



BUILDING AREAS	
BUILDING 1	13,934 SF
BUILDING 2	21,888 SF
BUILDING 3	20,001 SF

NOTE: EACH UNIT AREA CALCULATION INDICATED ON PLAN IS ROUNDED TO THE NEAREST WHOLE NUMBER RESULTING IN MINOR DISCREPANCIES FROM BUILDING AREAS WHEN TOTALLED.

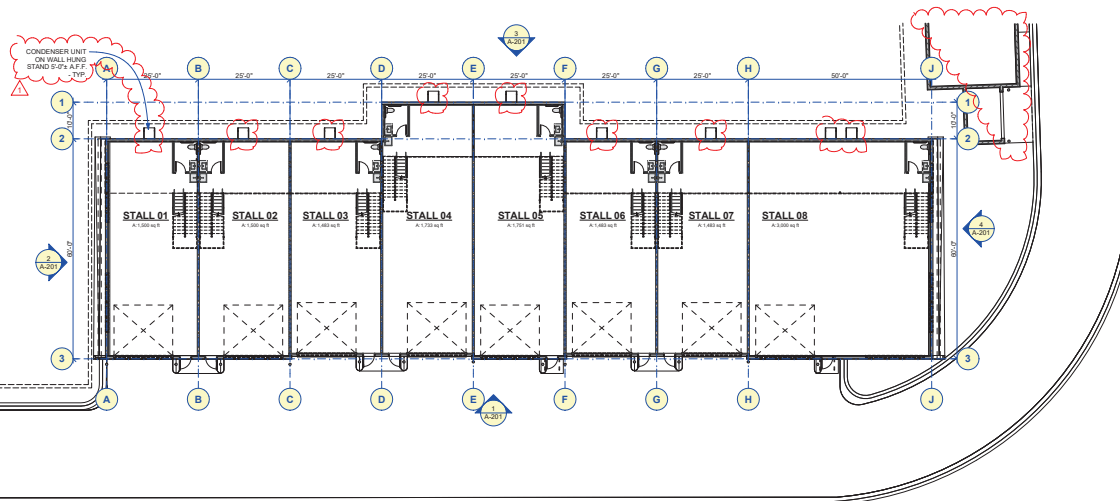

BUILDING 1 FLOOR PLAN

SCALE: 1/16" = 1'-0"

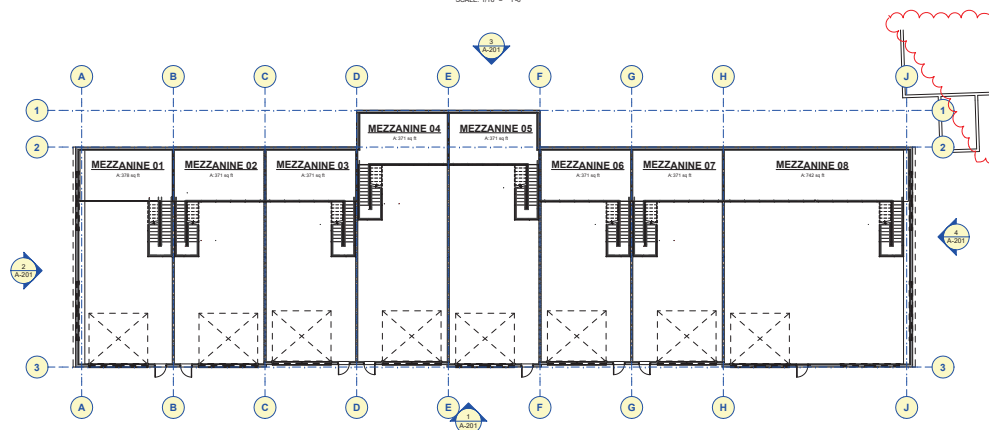

BUILDING 1 MEZZANINE PLAN

SCALE: 1/16" = 1'-0"



STERGAS & ASSOCIATES, AIA
 architecture • interior design • planning
 Tequesta, Florida | stergas@stergas.com | (561) 575-3360

Architectural for Site Plan Review:
BRIDGE ROAD AUTO CLUB

Revision 1- 1/16/2025: Response to Initial Submittal comments.


Building 1 Floor Plan
 1/16/2025

A-101


SCALE: 1/16" = 1'-0"

BUILDING AREAS	
BUILDING 1	13,934 SF
BUILDING 2	21,888 SF
BUILDING 3	20,001 SF

NOTE: EACH UNIT AREA CALCULATION INDICATED ON PLAN IS
 ROUNDED TO THE NEAREST WHOLE NUMBER, RESULTING IN
 MINOR DISCREPANCIES FROM BUILDING AREAS WHEN
 TOTALLED.

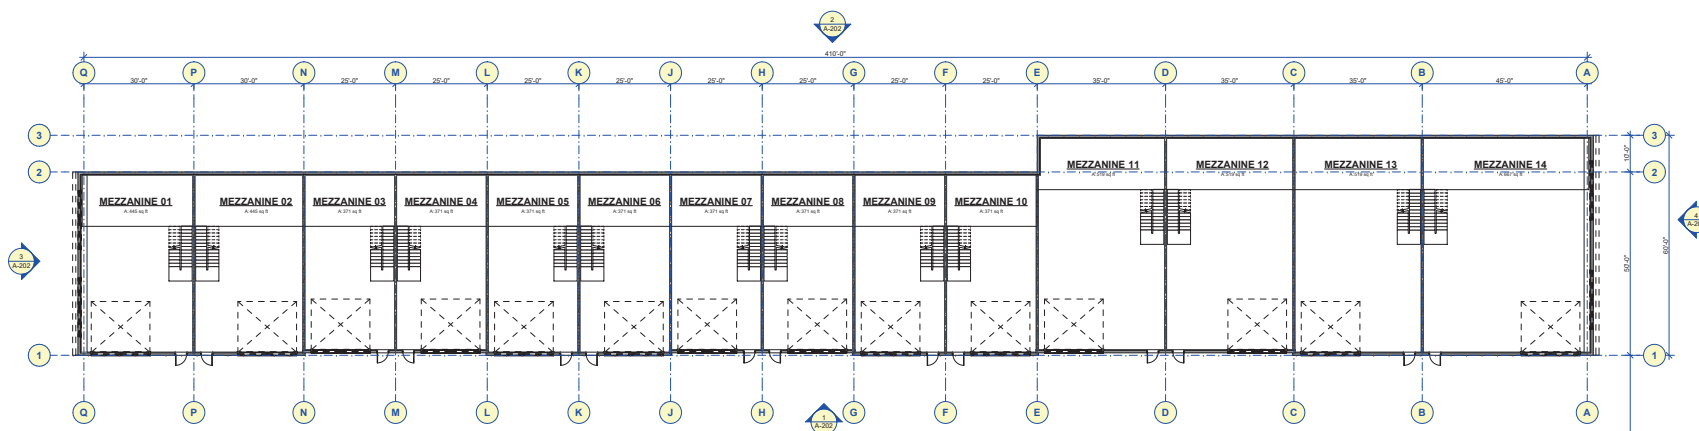

SCALE: 1/16" = 1'-0"

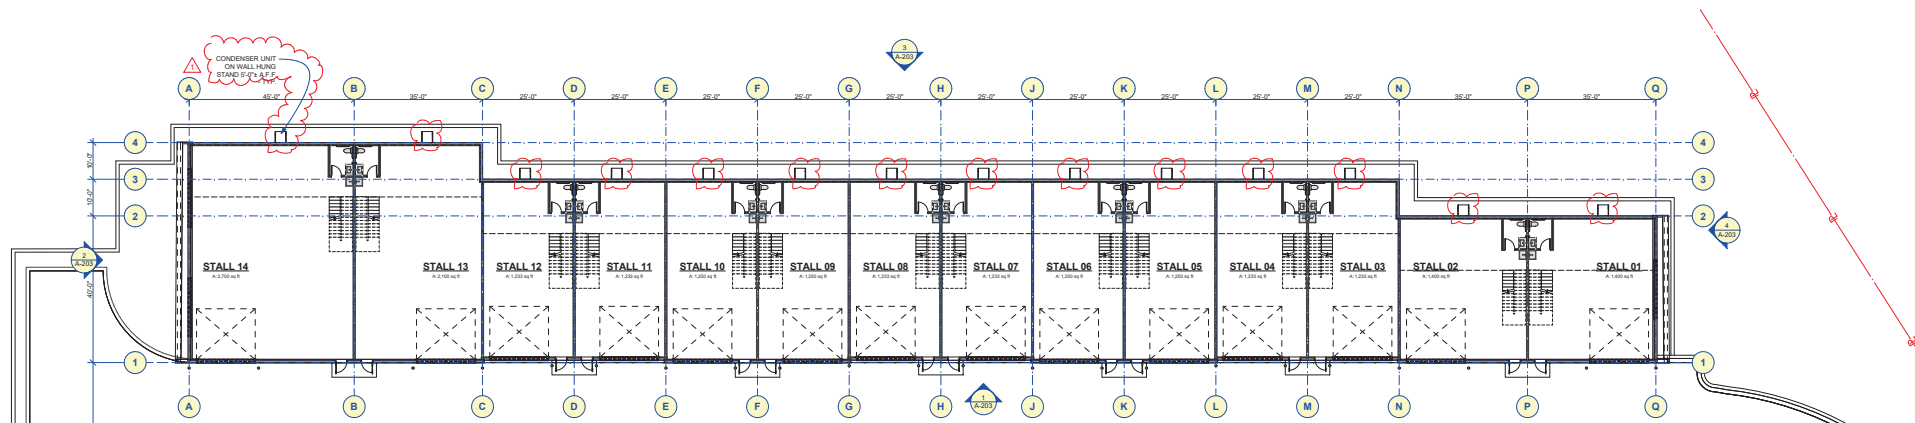


BUILDING 3 FLOOR PLAN

SCALE: 1/16" = 1'-0"

BUILDING AREAS	
BUILDING 1	13,934 SF
BUILDING 2	21,688 SF
BUILDING 3	29,001 SF

NOTE: EACH UNIT AREA CALCULATION INDICATED ON PLAN IS
 ROUNDED TO THE NEAREST WHOLE NUMBER RESULTING IN
 MINOR DISCREPANCIES FROM BUILDING AREAS WHEN
 TOTALLED.

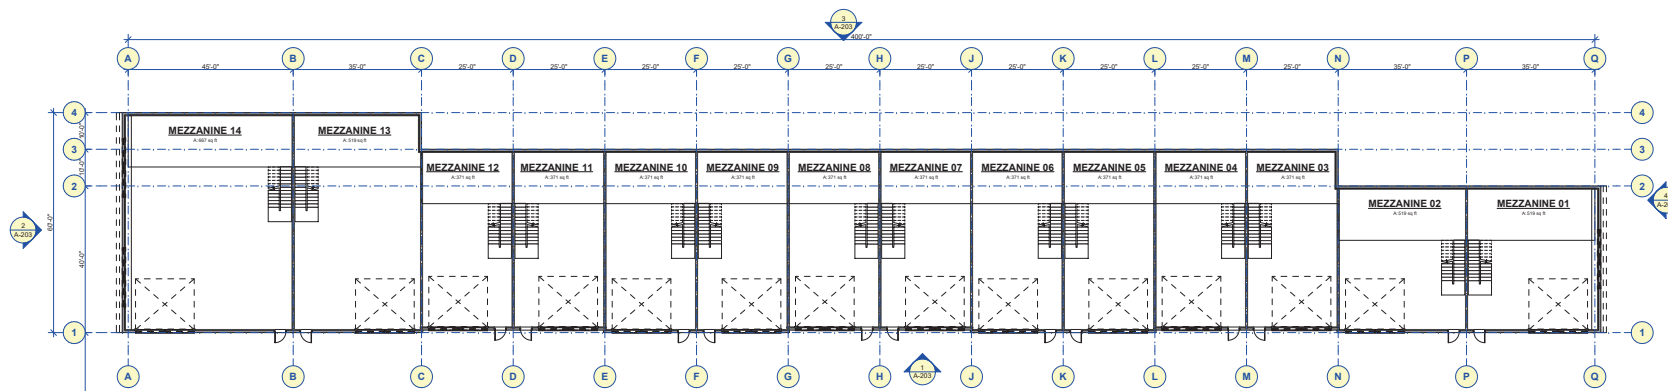

BUILDING 3 MEZZANINE PLAN

SCALE: 1/16" = 1'-0"




STERGAS & ASSOCIATES, AIA
 architecture • interior design • planning
 Tequesta, Florida | stergas@stergas.com | (561) 575-3360

Architectural for Site Plan Review:
BRIDGE ROAD AUTO CLUB

Revision 1- 1/16/2025: Response to Initial Submittal comments. Building 3 Floor Plans
 1/16/2025


A-103

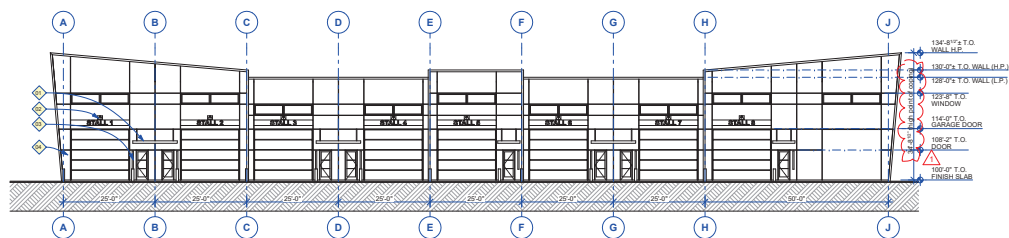

1 BUILDING 1 FRONT ELEVATION


SCALE: 1/16" = 1'-0"

EXTERIOR ELEVATION NOTES	
01	PREFAB ALUMINUM CANOPY
02	WALL MOUNTED DOWNWARD DIRECTED LIGHT FIXTURES - TYP. ABOVE GARAGE DOORS
03	WALL MOUNTED WALL WASH LIGHT FIXTURE - TYP. @ ENTRY DOORS
04	PAINTED TILTED CONCRETE PANELS - TYP.
05	CONCRETE UNIT ON WALL HANG STAND @ P.A.F.F.

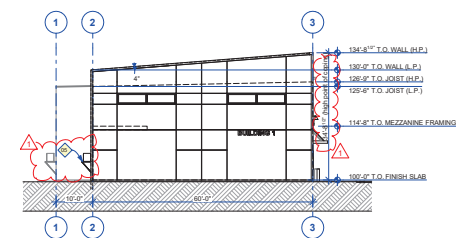


2 BUILDING 1 LEFT SIDE ELEVATION

SCALE: 1/16" = 1'-0"

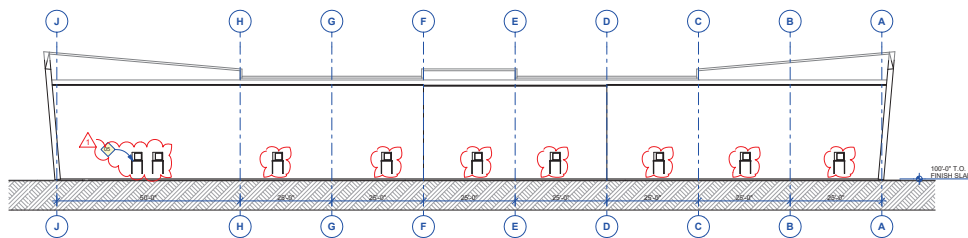

3 BUILDING 1 REAR ELEVATION

SCALE: 1/16" = 1'-0"

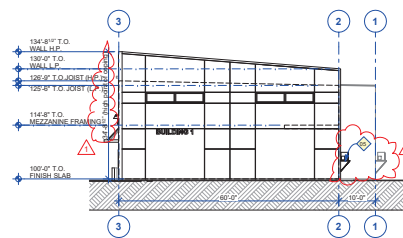

4 BUILDING 1 RIGHT SIDE ELEVATION

SCALE: 1/16" = 1'-0"




STERGAS & ASSOCIATES, AIA
architecture • interior design • planning
Tequesta, Florida | stergas@stergas.com | (561) 575-3360

Architectural for Site Plan Review:
BRIDGE ROAD AUTO CLUB


Revision 1- 1/16/2025: Response to Initial Submittal comments.

Building 1 Elevations
1/16/2025

A-201

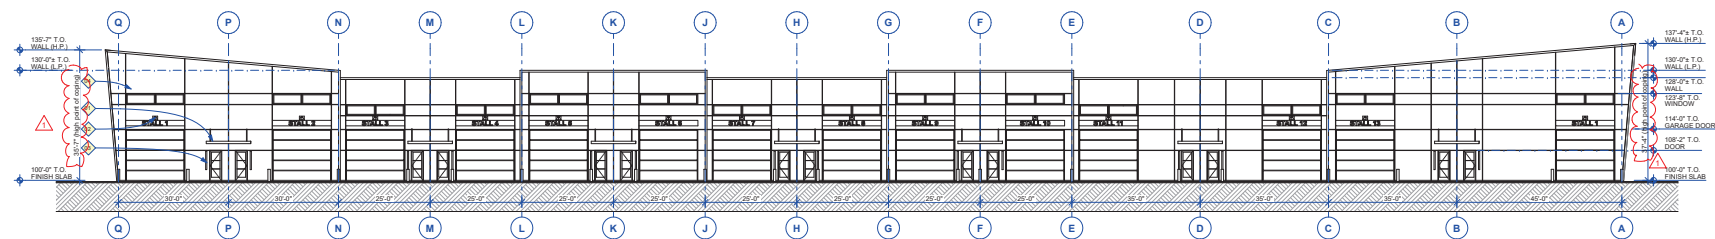


1
A-202 BUILDING 2 FRONT ELEVATION
SCALE: 1/16" = 1'-0"

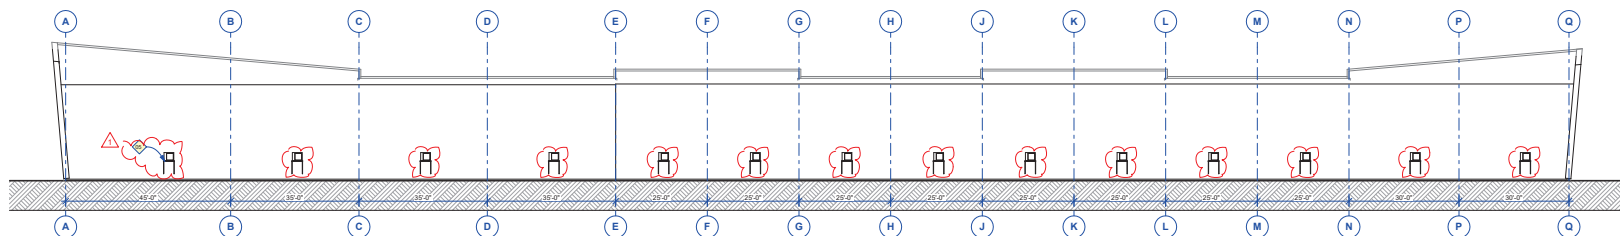


2
A-202 BUILDING 2 REAR ELEVATION
SCALE: 1/16" = 1'-0"

EXTERIOR ELEVATION NOTES	
01	PREFAB ALUMINUM CANOPY
02	WALL MOUNTED DOWNWARD DIRECTED LIGHT FIXTURES - TYP. ABOVE GARAGE DOORS
03	WALL MOUNTED WALL WASH LIGHT FIXTURE - TYP. @ ENTRY DOORS
04	PAINTED TILTED CONCRETE PANELS - TYP.
05	WOMEN'S UNION WALL HUNG STANDS @ A.F.F.

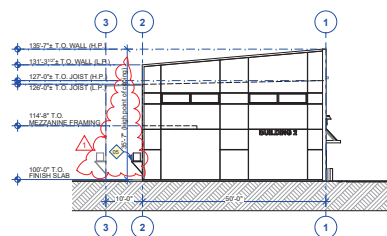


3
A-202 BUILDING 2 LEFT SIDE ELEVATION
SCALE: 1/16" = 1'-0"

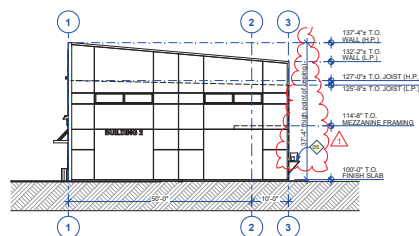


4
A-202 BUILDING 2 RIGHT SIDE ELEVATION
SCALE: 1/16" = 1'-0"



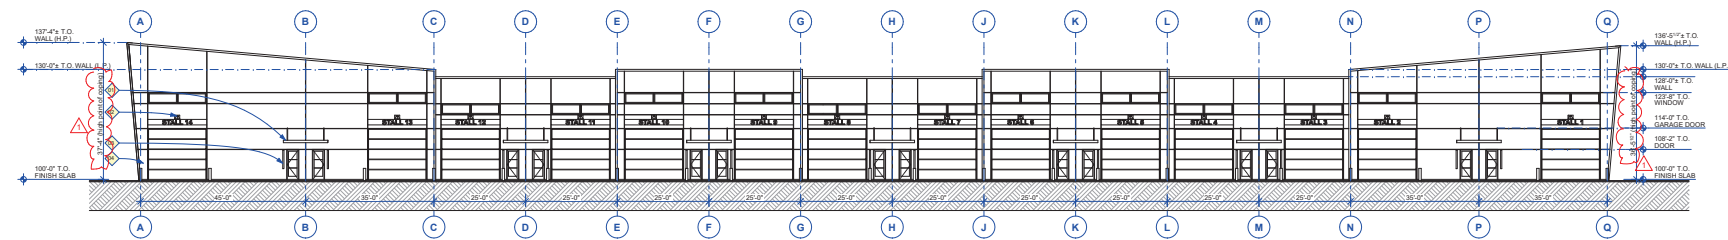

1
A-203 BUILDING 3 FRONT ELEVATION


SCALE: 1/16" = 1'-0"

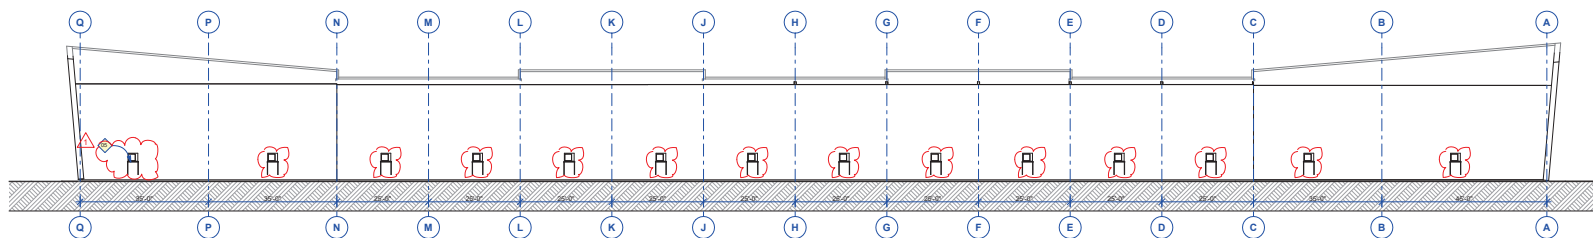

3
A-203 BUILDING 3 REAR ELEVATION


SCALE: 1/16" = 1'-0"

EXTERIOR ELEVATION NOTES	
01	PREFAB ALUMINUM CANOPY
02	WALL MOUNTED DOWNWARD DIRECTED LIGHT FIXTURES - TYP ABOVE GARAGE DOORS
03	WALL MOUNTED WALL WASH LIGHT FIXTURE - TYP @ ENTRY DOORS
04	PAINTED TILTED CONCRETE PANELS - TYP
05	CONDENSER UNIT ON WALL HUNG STAND 3'-0" x 4'-0"

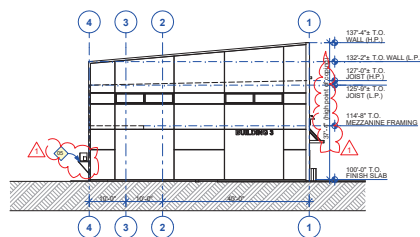

2
A-203 BUILDING 3 LEFT ELEVATION

SCALE: 1/16" = 1'-0"

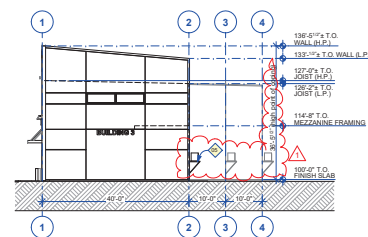

4
A-203 BUILDING 3 RIGHT SIDE ELEVATION

SCALE: 1/16" = 1'-0"




STERGAS & ASSOCIATES, AIA
architecture • interior design • planning
Tequesta, Florida | stergas@stergas.com | (561) 575-3360

Architectural for Site Plan Review:
BRIDGE ROAD AUTO CLUB

Revision 1- 1/16/2025: Response to Initial Submittal comments.

Building 3 Elevations
1/16/2025


A-203

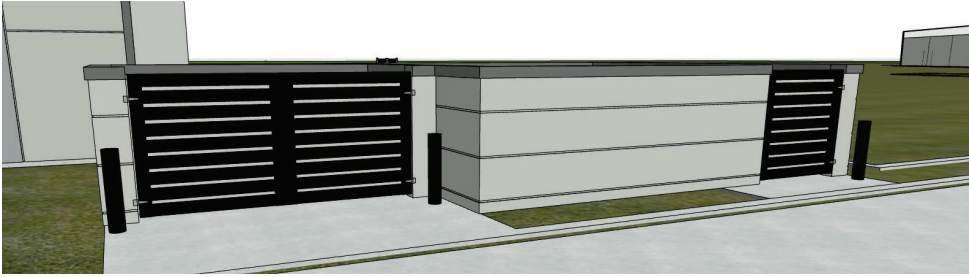

DUMPSTER & LIFT STATION VIEW




GATE VIEW

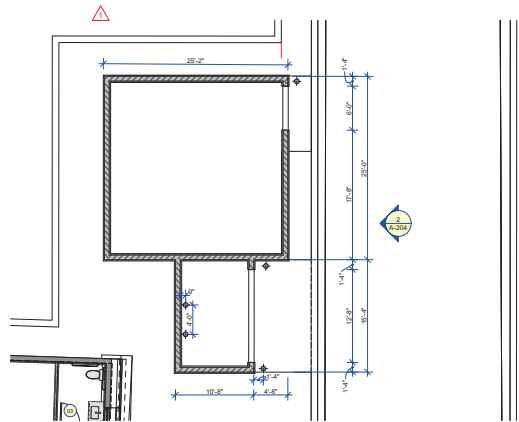


1 DUMPSTER & LIFT STATION ENCLOSURE PLAN

SCALE: 1/8" = 1'-0"

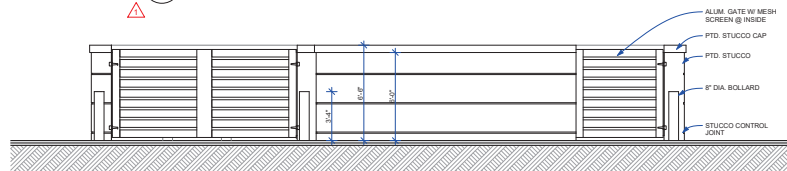


2 FRONT ELEVATION

SCALE: 1/4" = 1'-0"

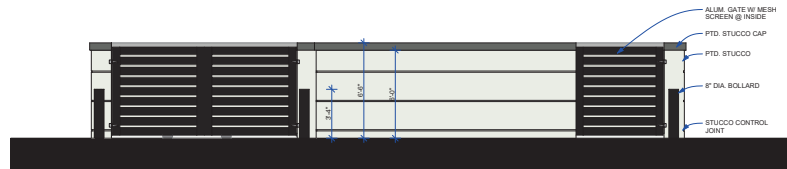


3 FRONT ELEVATION

SCALE: 1/4" = 1'-0"

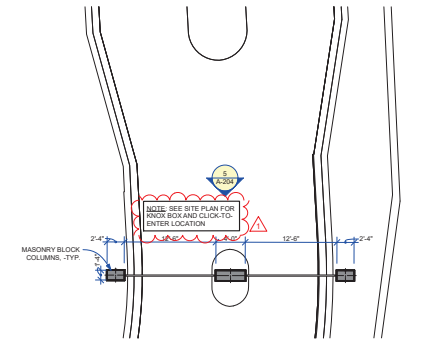


4 GATE PLAN

SCALE: 1/8" = 1'-0"

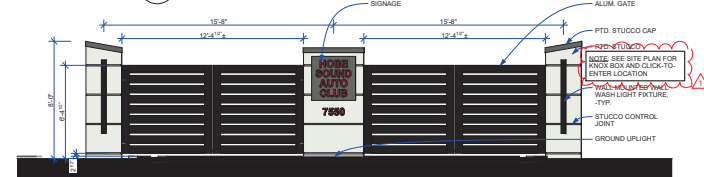

5 FRONT ELEVATION

SCALE: 1/4" = 1'-0"

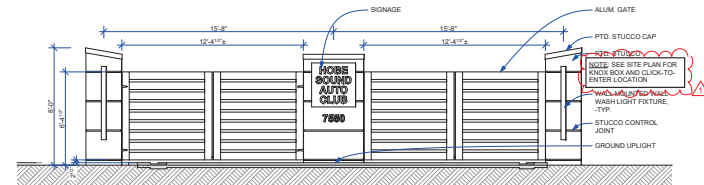

6 FRONT ELEVATION

SCALE: 1/4" = 1'-0"



STERGAS & ASSOCIATES, AIA
architecture • interior design • planning
Tequesta, Florida | stergas@stergas.com | (561) 575-3360

Architectural for Site Plan Review:
BRIDGE ROAD AUTO CLUB

Revision 1- 1/16/2025: Response to Initial Submittal comments.

Entry & Exit Gate Plan & Elevations
1/16/2025

A-204



3D SIDE VIEW



INTERIOR VIEW



BUILDING 2 & 3



BUILDING 2 & 3 DRIVE



BUILDING 1 3D FRONT VIEW

