




SCALE: 3/16" = 1'-0"

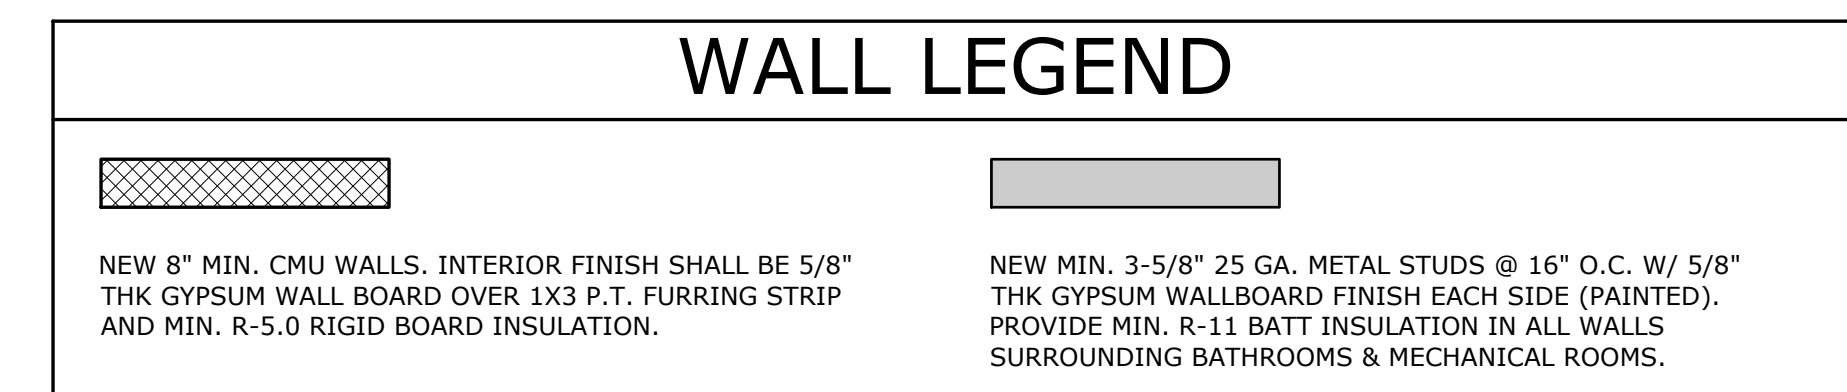

SCALE: 3/16" = 1'-0"

First Floor Plan

WALL LEGEND



NEW 8" MIN. CMU WALLS. INTERIOR FINISH SHALL BE 5/8" THK GYPSUM WALL BOARD OVER 1X3 P.T. FURRING STRIP AND MIN. R-5.0 RIGID BOARD INSULATION.	NEW MIN. 3-5/8" 25 GA. METAL STUDS @ 16" O.C. W/ 5/8" THK GYPSUM WALLBOARD FINISH EACH SIDE (PAINTED). PROVIDE MIN. R-11 BATT INSULATION IN ALL WALLS SURROUNDING BATHROOMS & MECHANICAL ROOMS.



Copyright

2081 SE Ocean Blvd. Suite 1A
Stuart, FL 34996
O: (772) 220-4411
www.n2archdesign.com

architecture + design

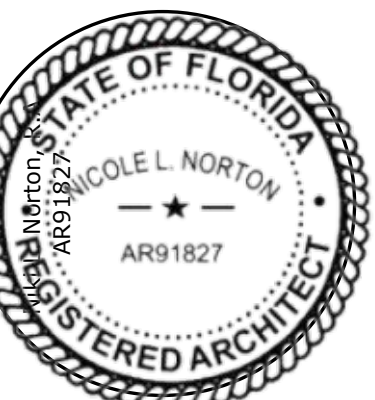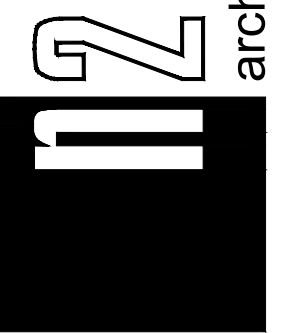

This item has been electronically signed and sealed by NICOLE WORTON, RA, LEED AP using a Digital Signature and Date. Printed Copies are not considered signed and sealed and the signature must be verified on any electronic copies.

Port Cove
NW Dixie Highway
Jensen Beach, FL 34957
Brad Stanis, OKSJR
(954) 592-4426

Rev. #	Date
1	-
2	18-Nov-2021 Development Review Comments
Project Number	19-0511
Status	Site Submittal
Issue Date	18-Nov-2021
Sheet Number	A33

A2.2

Second Floor Plan

GENERAL NOTES

1. All exterior windows and doors shall be hurricane impact resistant.
2. All roofing & exterior colors to be approved neutrals.



1 - FRONT ELEVATION (UNIT COUNT VARIES, RE: SITE PLAN)

SCALE: 3/16" = 1'-0"



2 - REAR ELEVATIONS (UNIT COUNT VARIES, RE: SITE PLAN)


SCALE: 3/16" = 1'-0"

Copyright ©

Commercial + Residential
2001 SE Ocean Blvd Suite 1A
Stuart, FL 34996
O: (772) 220-4411
www.r2archdesign.com



architecture + design

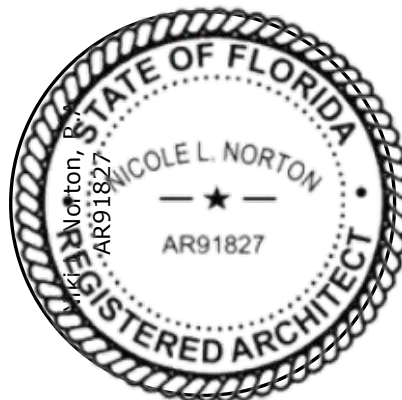

signed and sealed by NICOLE
NORTON, RA, LEED AP using a
Digital Signature and Date. Printed
Copies are not considered signed
and sealed and the signature must
be verified on any electronic
copies.

Port Cove
NW Dixie Highway
Jensen Beach, FL 34957
Brad Stanis, OKSJN Jensen, LLC
(954) 592-4426

Rev. #	Date
1	09-Jul-2019 Development Review Comments
2	18-Nov-2021 Development Review Comments

Project Number	19-0511
Status	Site Submittal
Issue date	18-Nov-2021
Sheet	A3.1

Exterior Elevations


GENERAL NOTES

1.

All exterior windows and doors shall be hurricane impact resistant.


2.

All roofing & exterior colors to be approved neutrals.

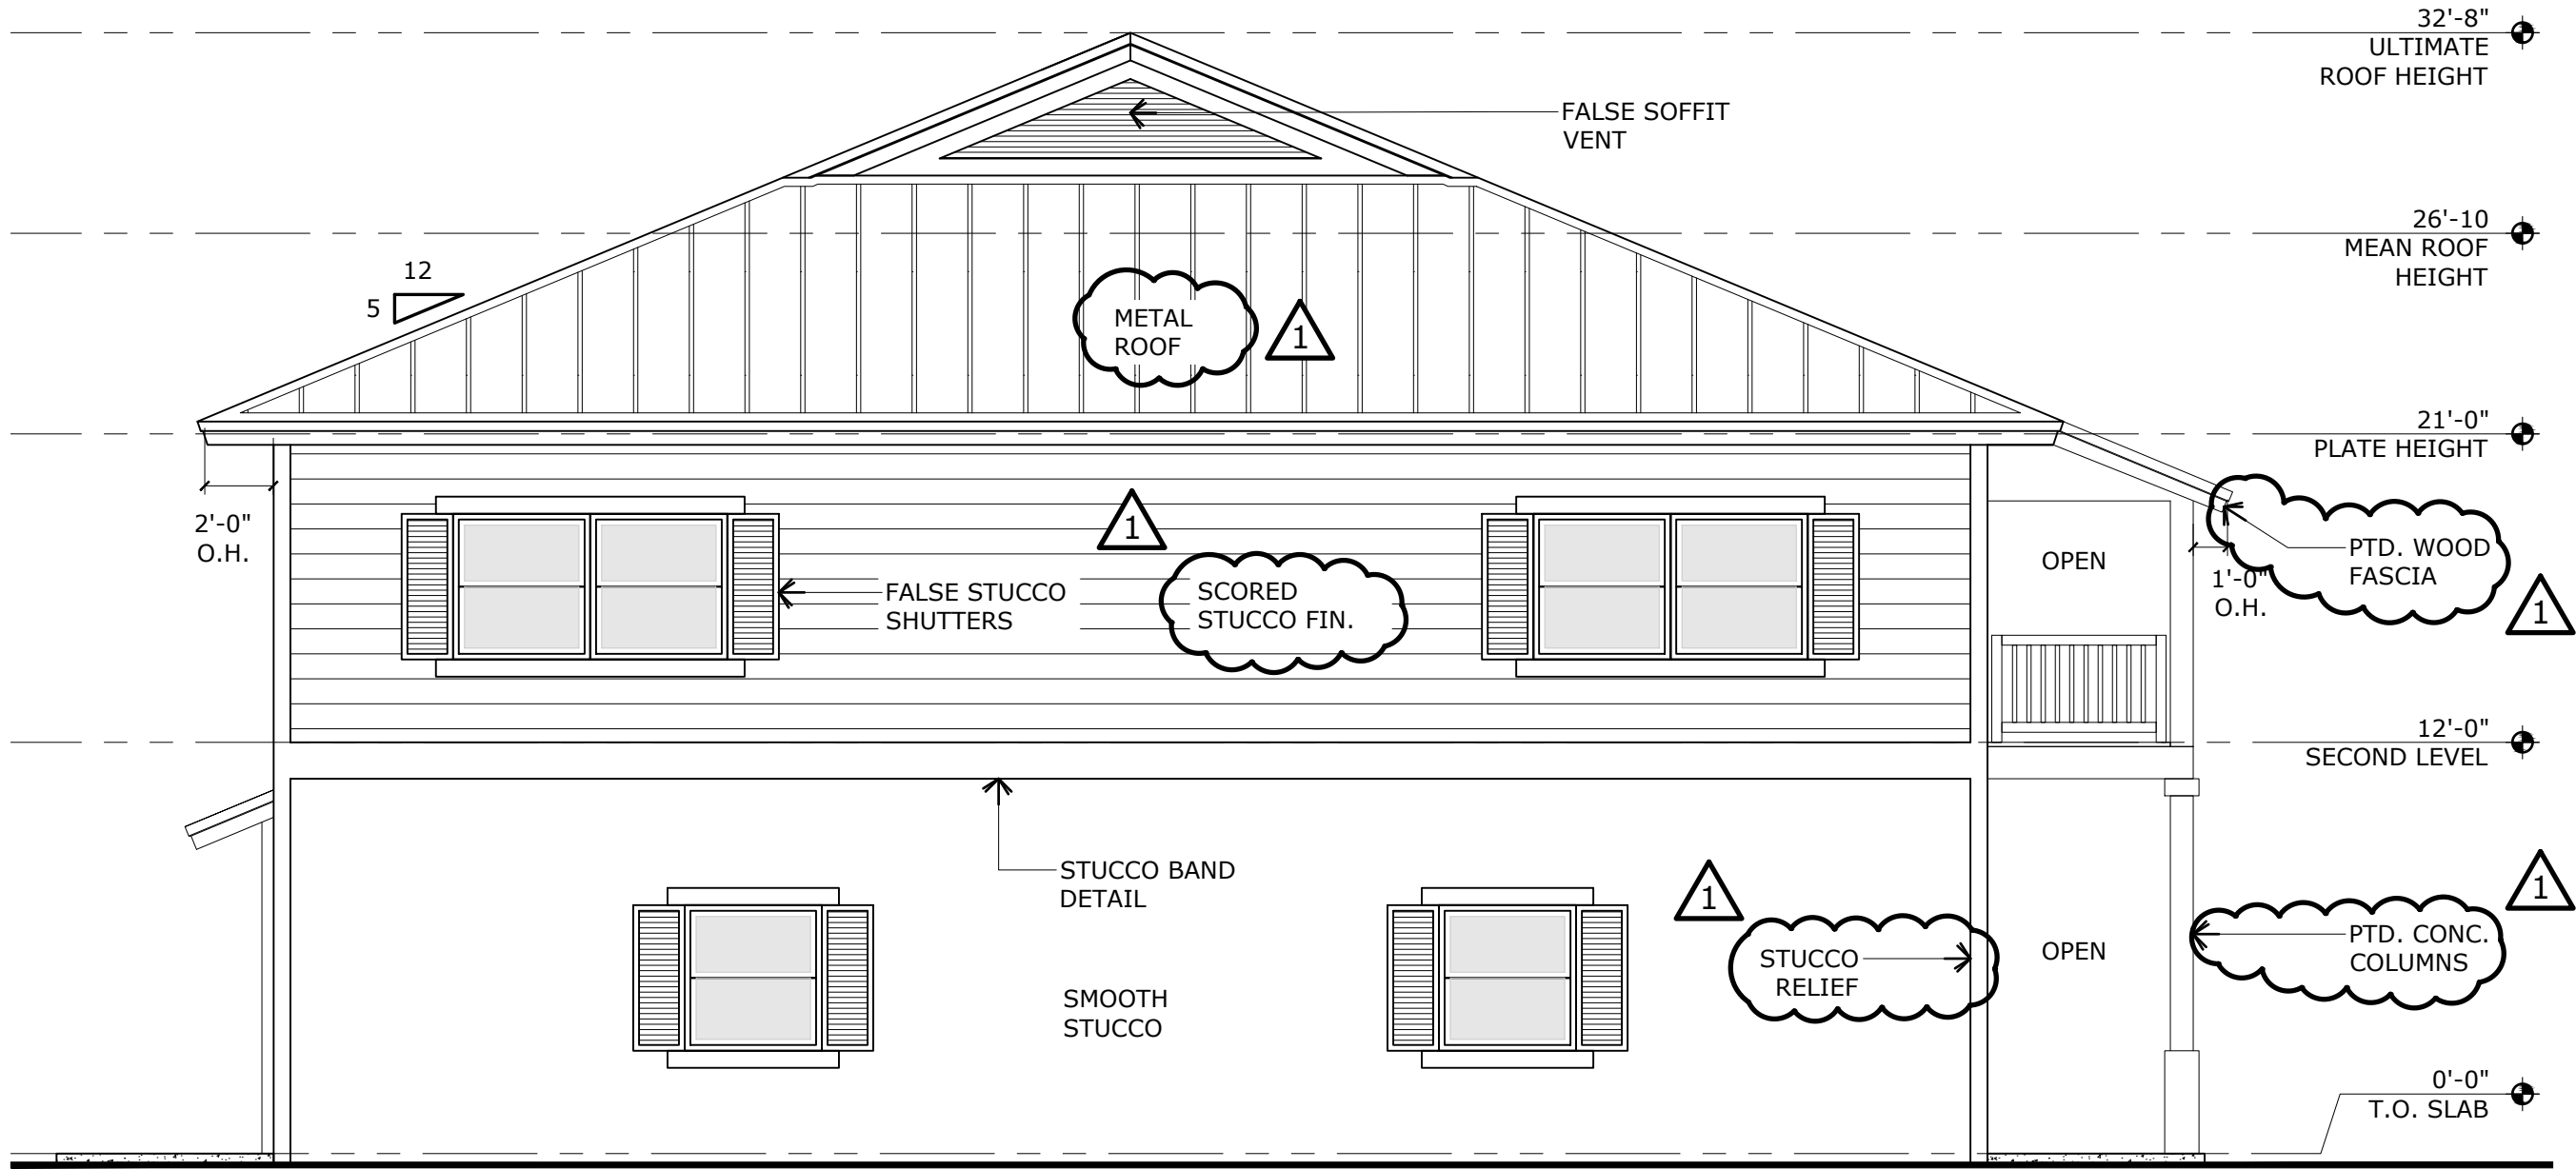


1 - TYPICAL SIDE ELEVATION

SCALE: 3/16" = 1'-0"

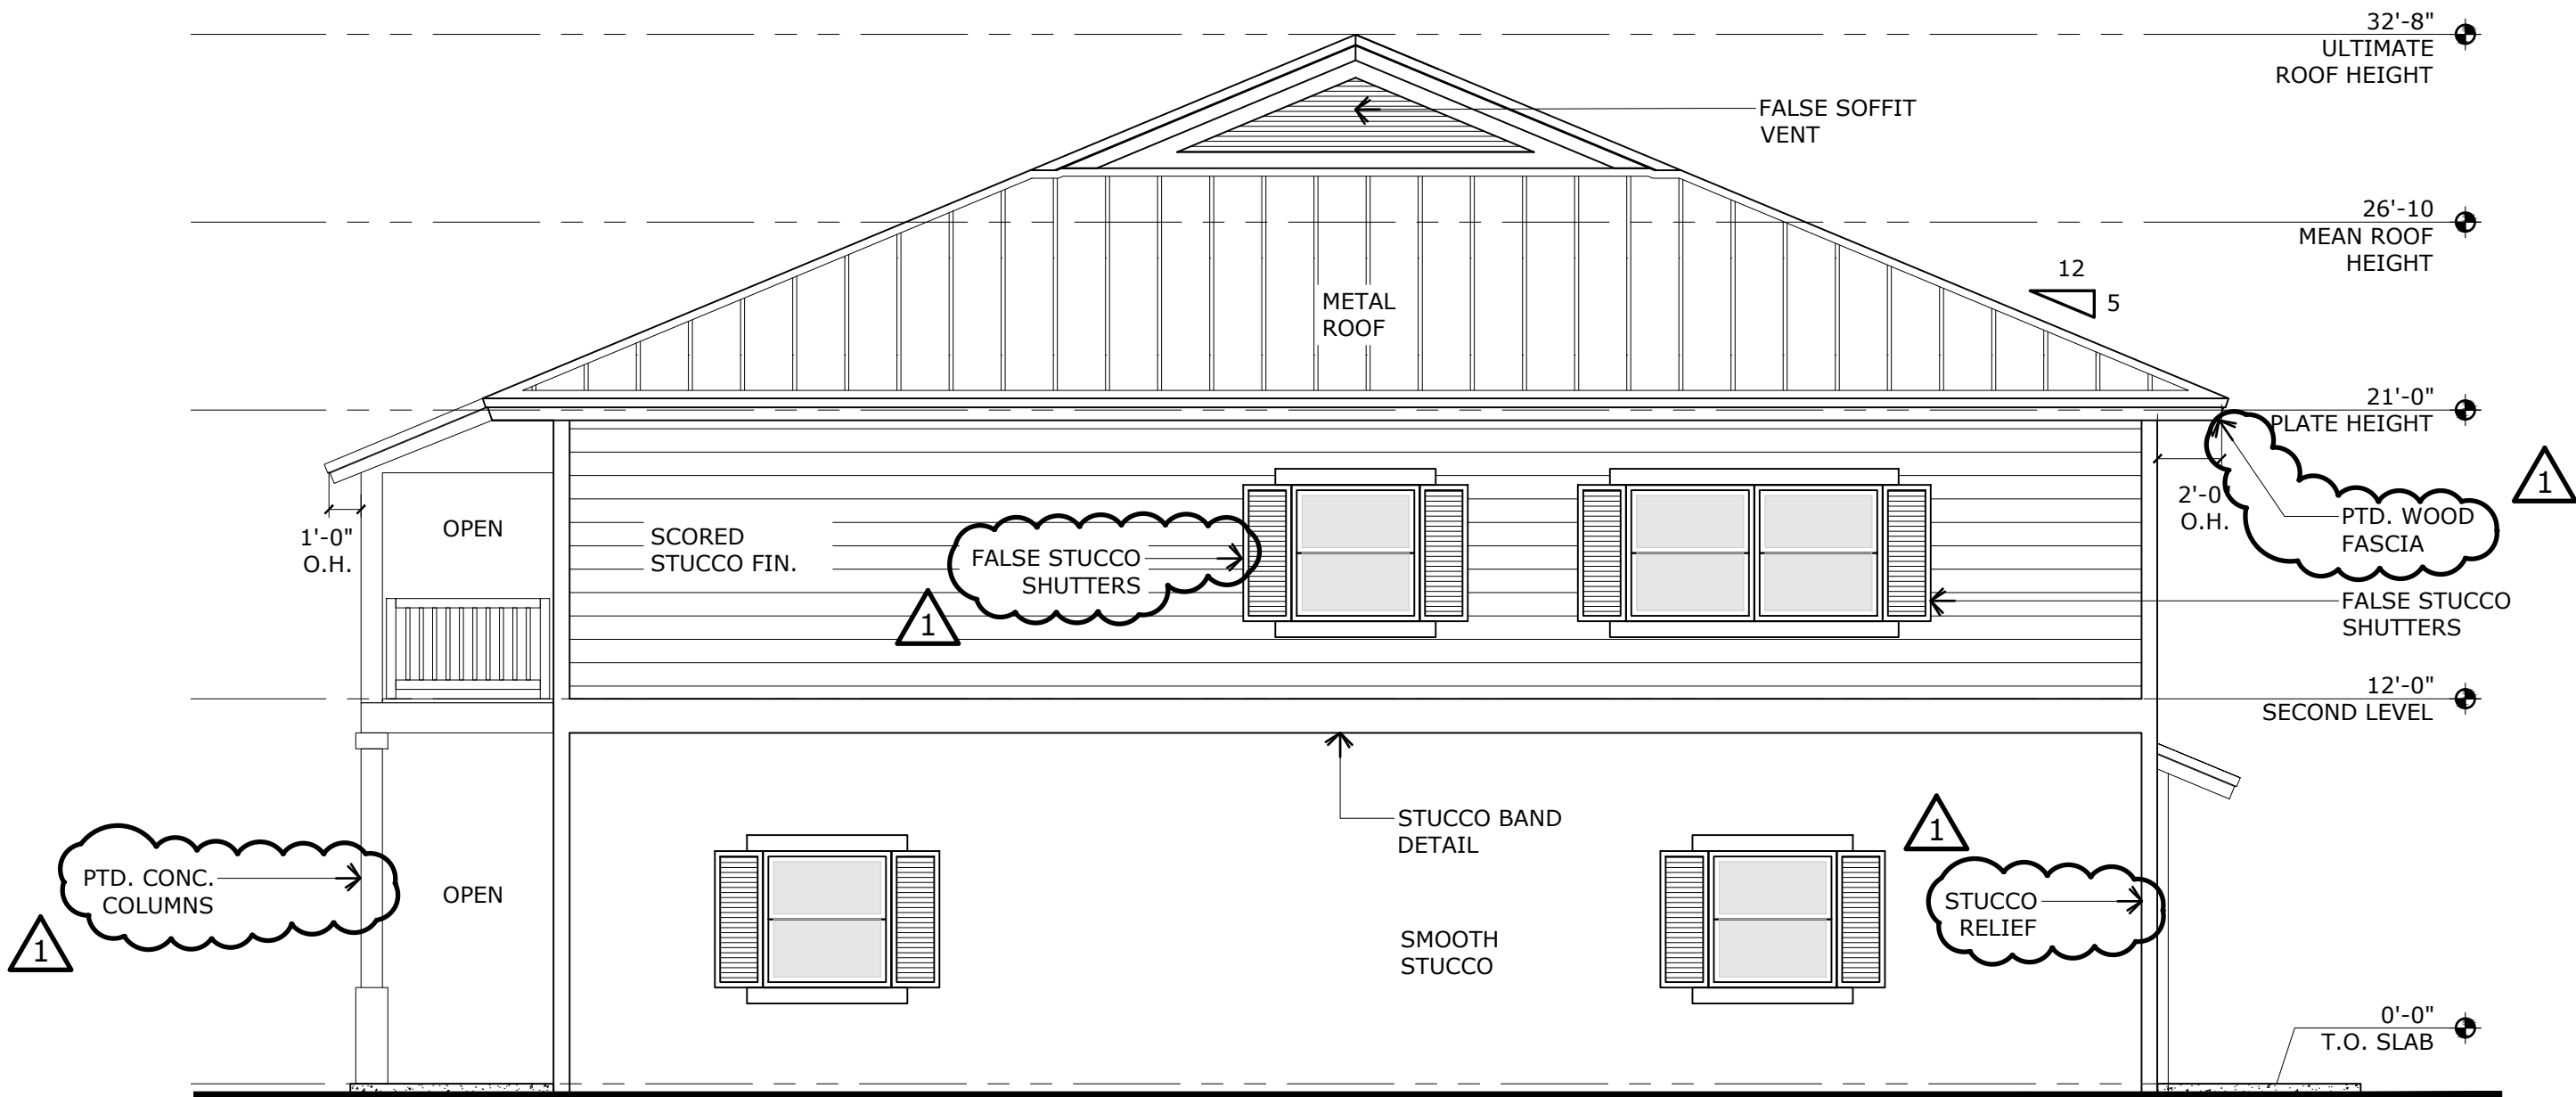

2 - TYPICAL SIDE ELEVATION

SCALE: 3/16" = 1'-0"


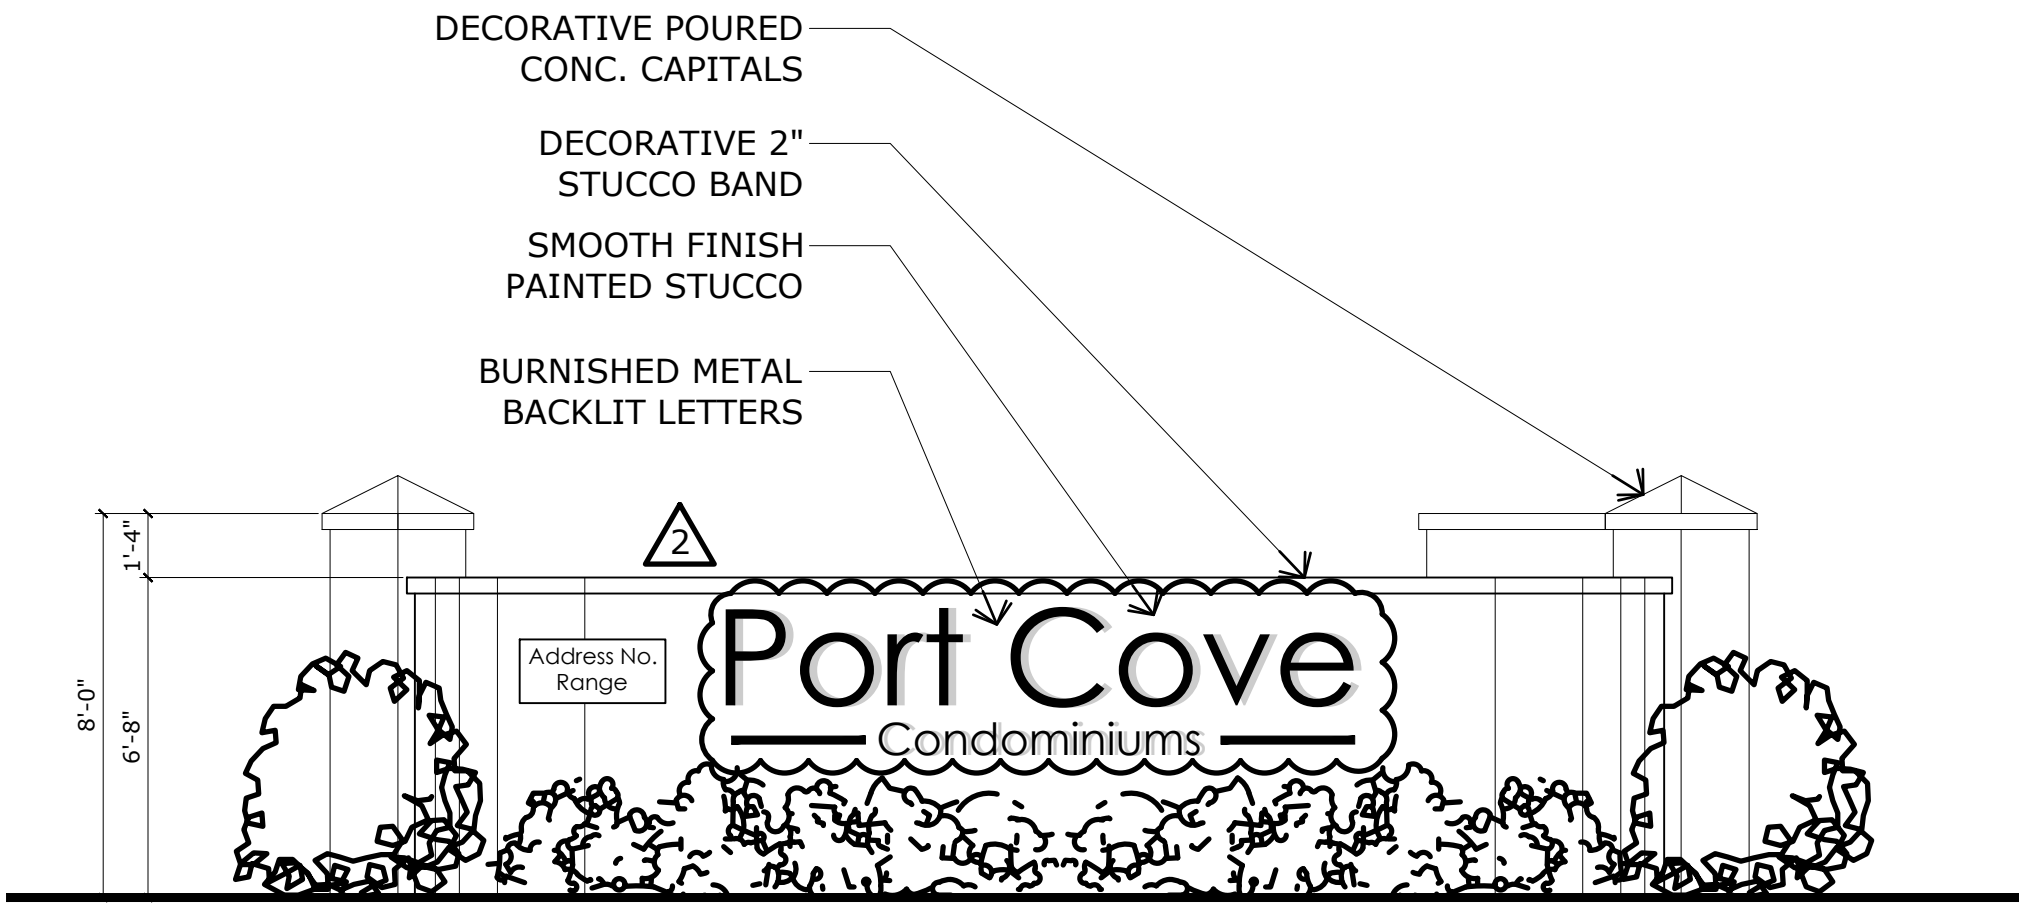


3 - MONUMENT SIGN ELEVATION

SCALE: 1/4" = 1'-0"

Copyright ©
All drawings and written material appearing herein are the property of the Architect and shall not be duplicated, distributed, disclosed, or used in any form without the written consent of the Architect. Penalties shall apply where user duplicates Architect's work, without Architect's written consent.

Commercial + Residential
2081 SE Ocean Blvd. Suite 1A
Stuart, FL 34986
O: (772) 220-4411
www.n2archdesign.com

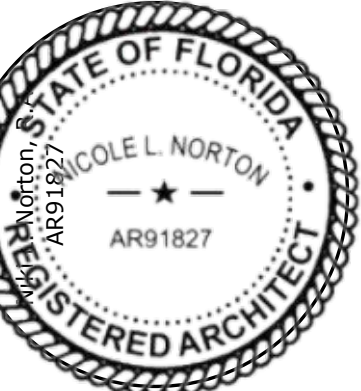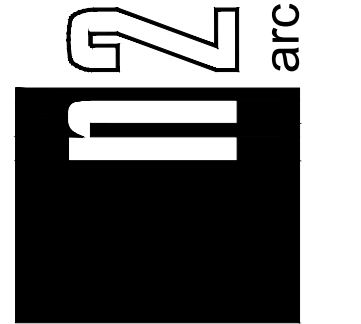

This document has been electronically signed and sealed by NICOLE NORTON, RA, LEED AP using a Digital Signature and Date. Printed Copies are not considered signed and sealed and the signature must be verified on any electronic copies.

Port Cove
NW Dixie Highway
Jensen Beach, FL 34957
Brad Stanits, OKSIN Jensen, LLC
(954) 592-4426

Rev. #	Date
1	09-Jul-2019
2	18-Nov-2021

Project Number	19-0511
Status	Site Submittal
Issue date	18-Nov-2021
Sheet	A3.2

Exterior Elevations